


Notes:
 Do not scale
 Check measurements should be taken onsite
 Based on base build drawings produced by others



REV.	DATE	DESCRIPTION

Client

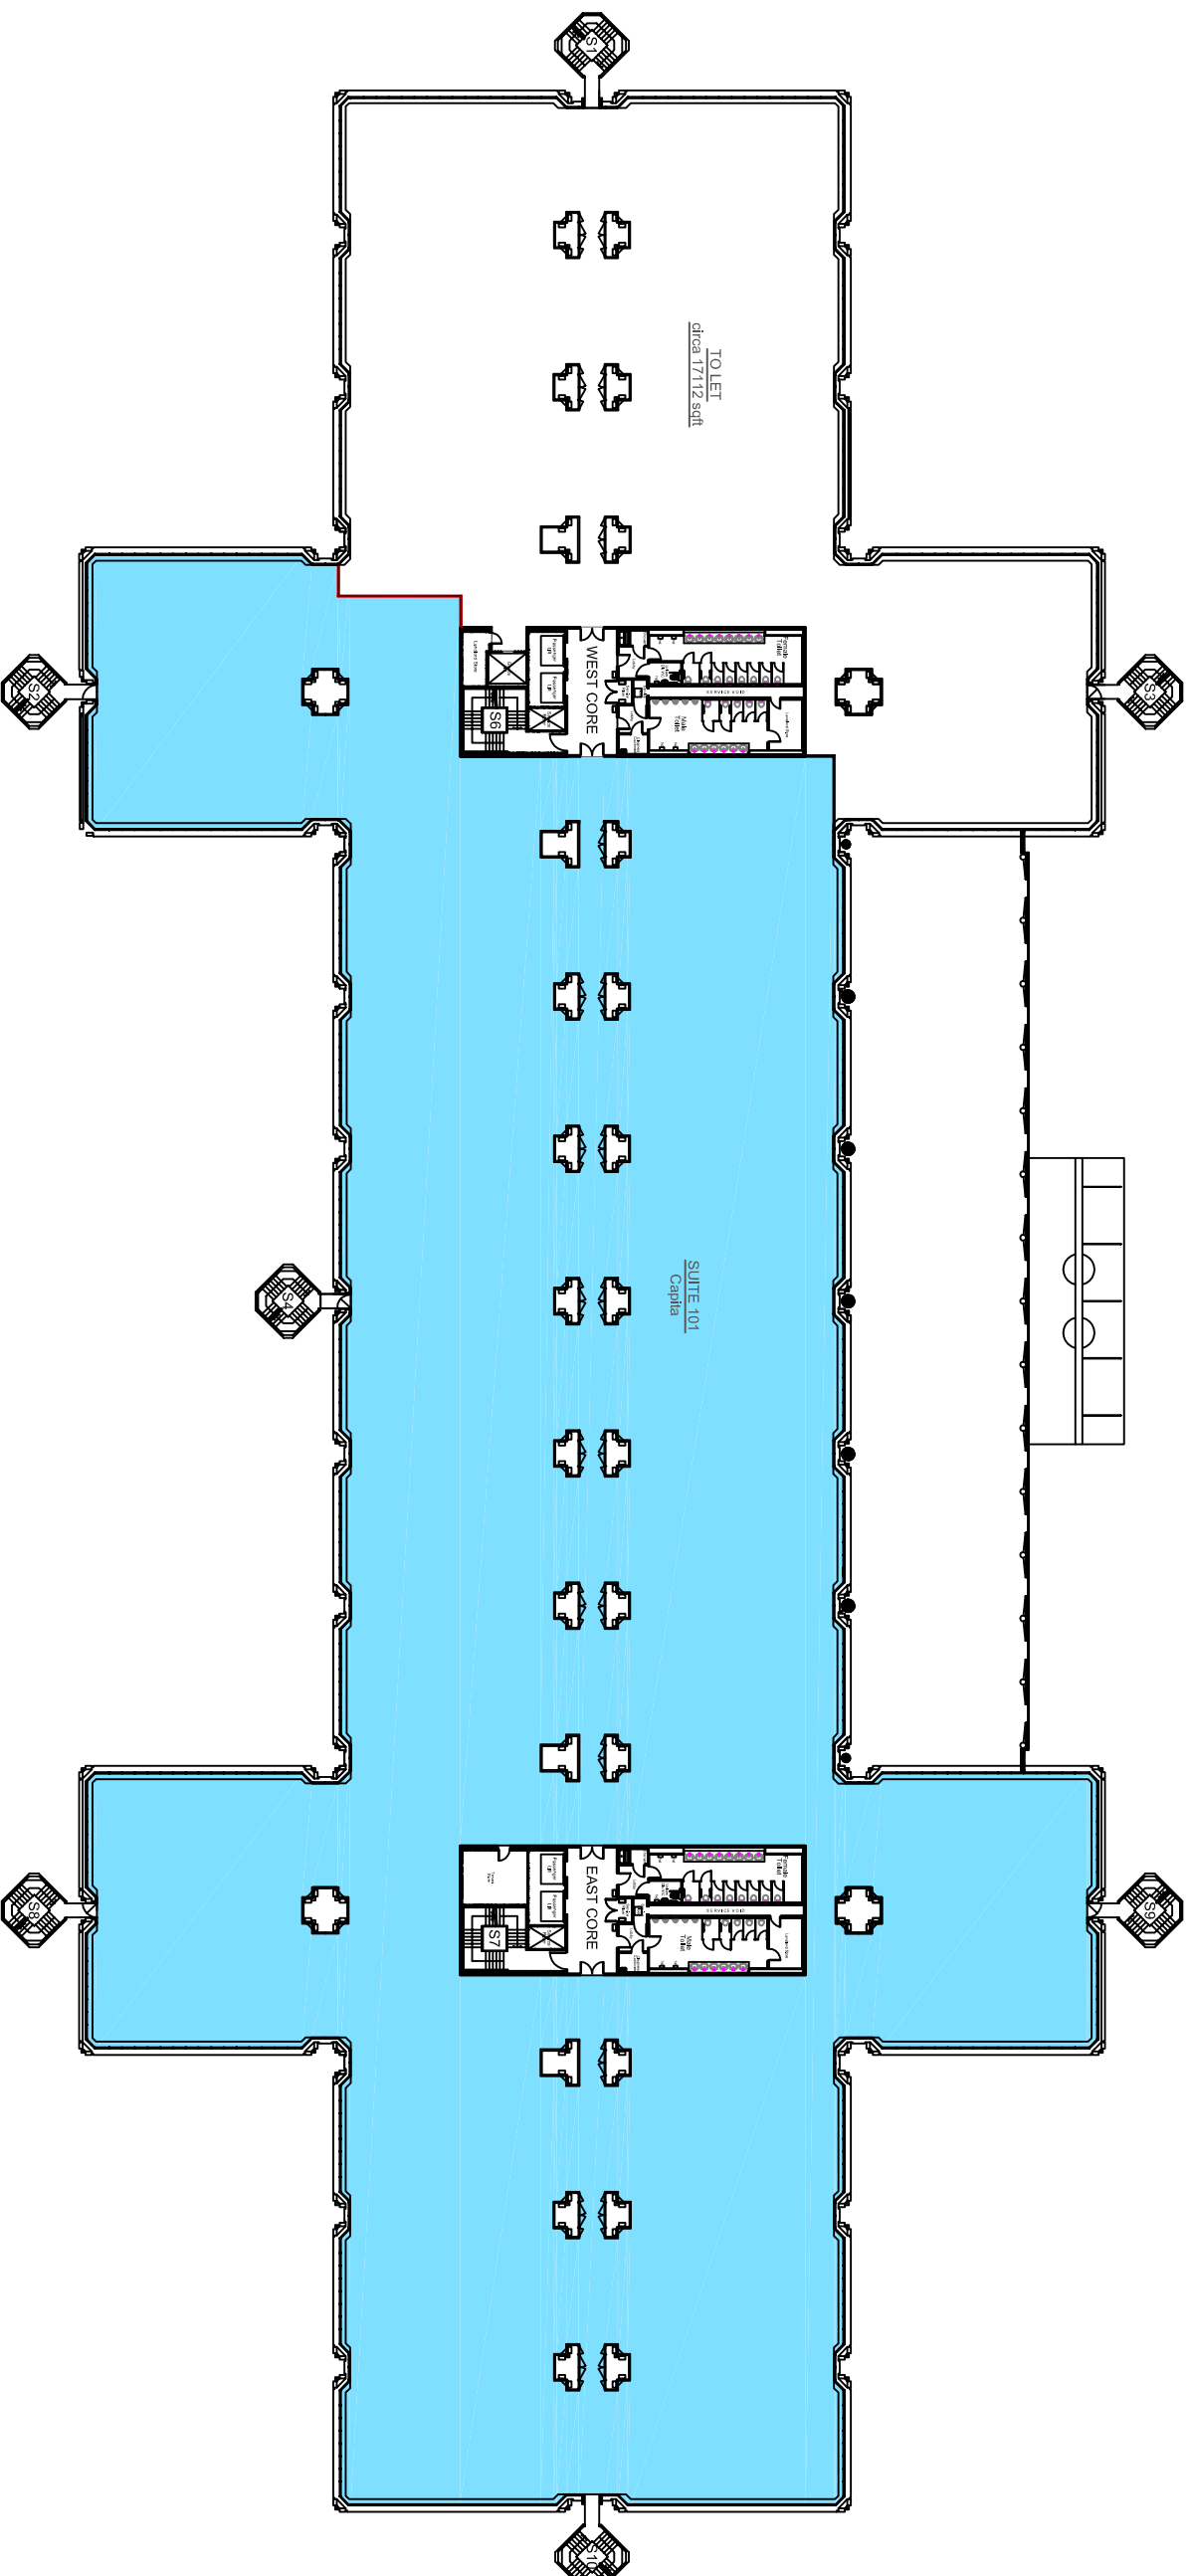

NORTH HARBOUR UNIT TRUST
 c/o HIGHCROSS STRATEGIC ADVISORS LTD

Project
 1000 LAKESIDE
 NORTH HARBOUR

Title
 FIRST FLOOR AS-BUILT



building surveyors
 10 Saville Place Clifton Bristol BS8 4EJ
 T: 0117 900 1638 - F: 0117 970 6006

Date
 OCTOBER 2011

Drawn by
 KP

Scale
 NTS

Checked by
 SH

Drawing No.

MASTER LAYOUT

Rev.

T