


Notes:  
 Do not scale  
 Check measurements should be taken onsite  
 Based on base build drawings produced by others



REV.	DATE.	DESCRIPTION

Client

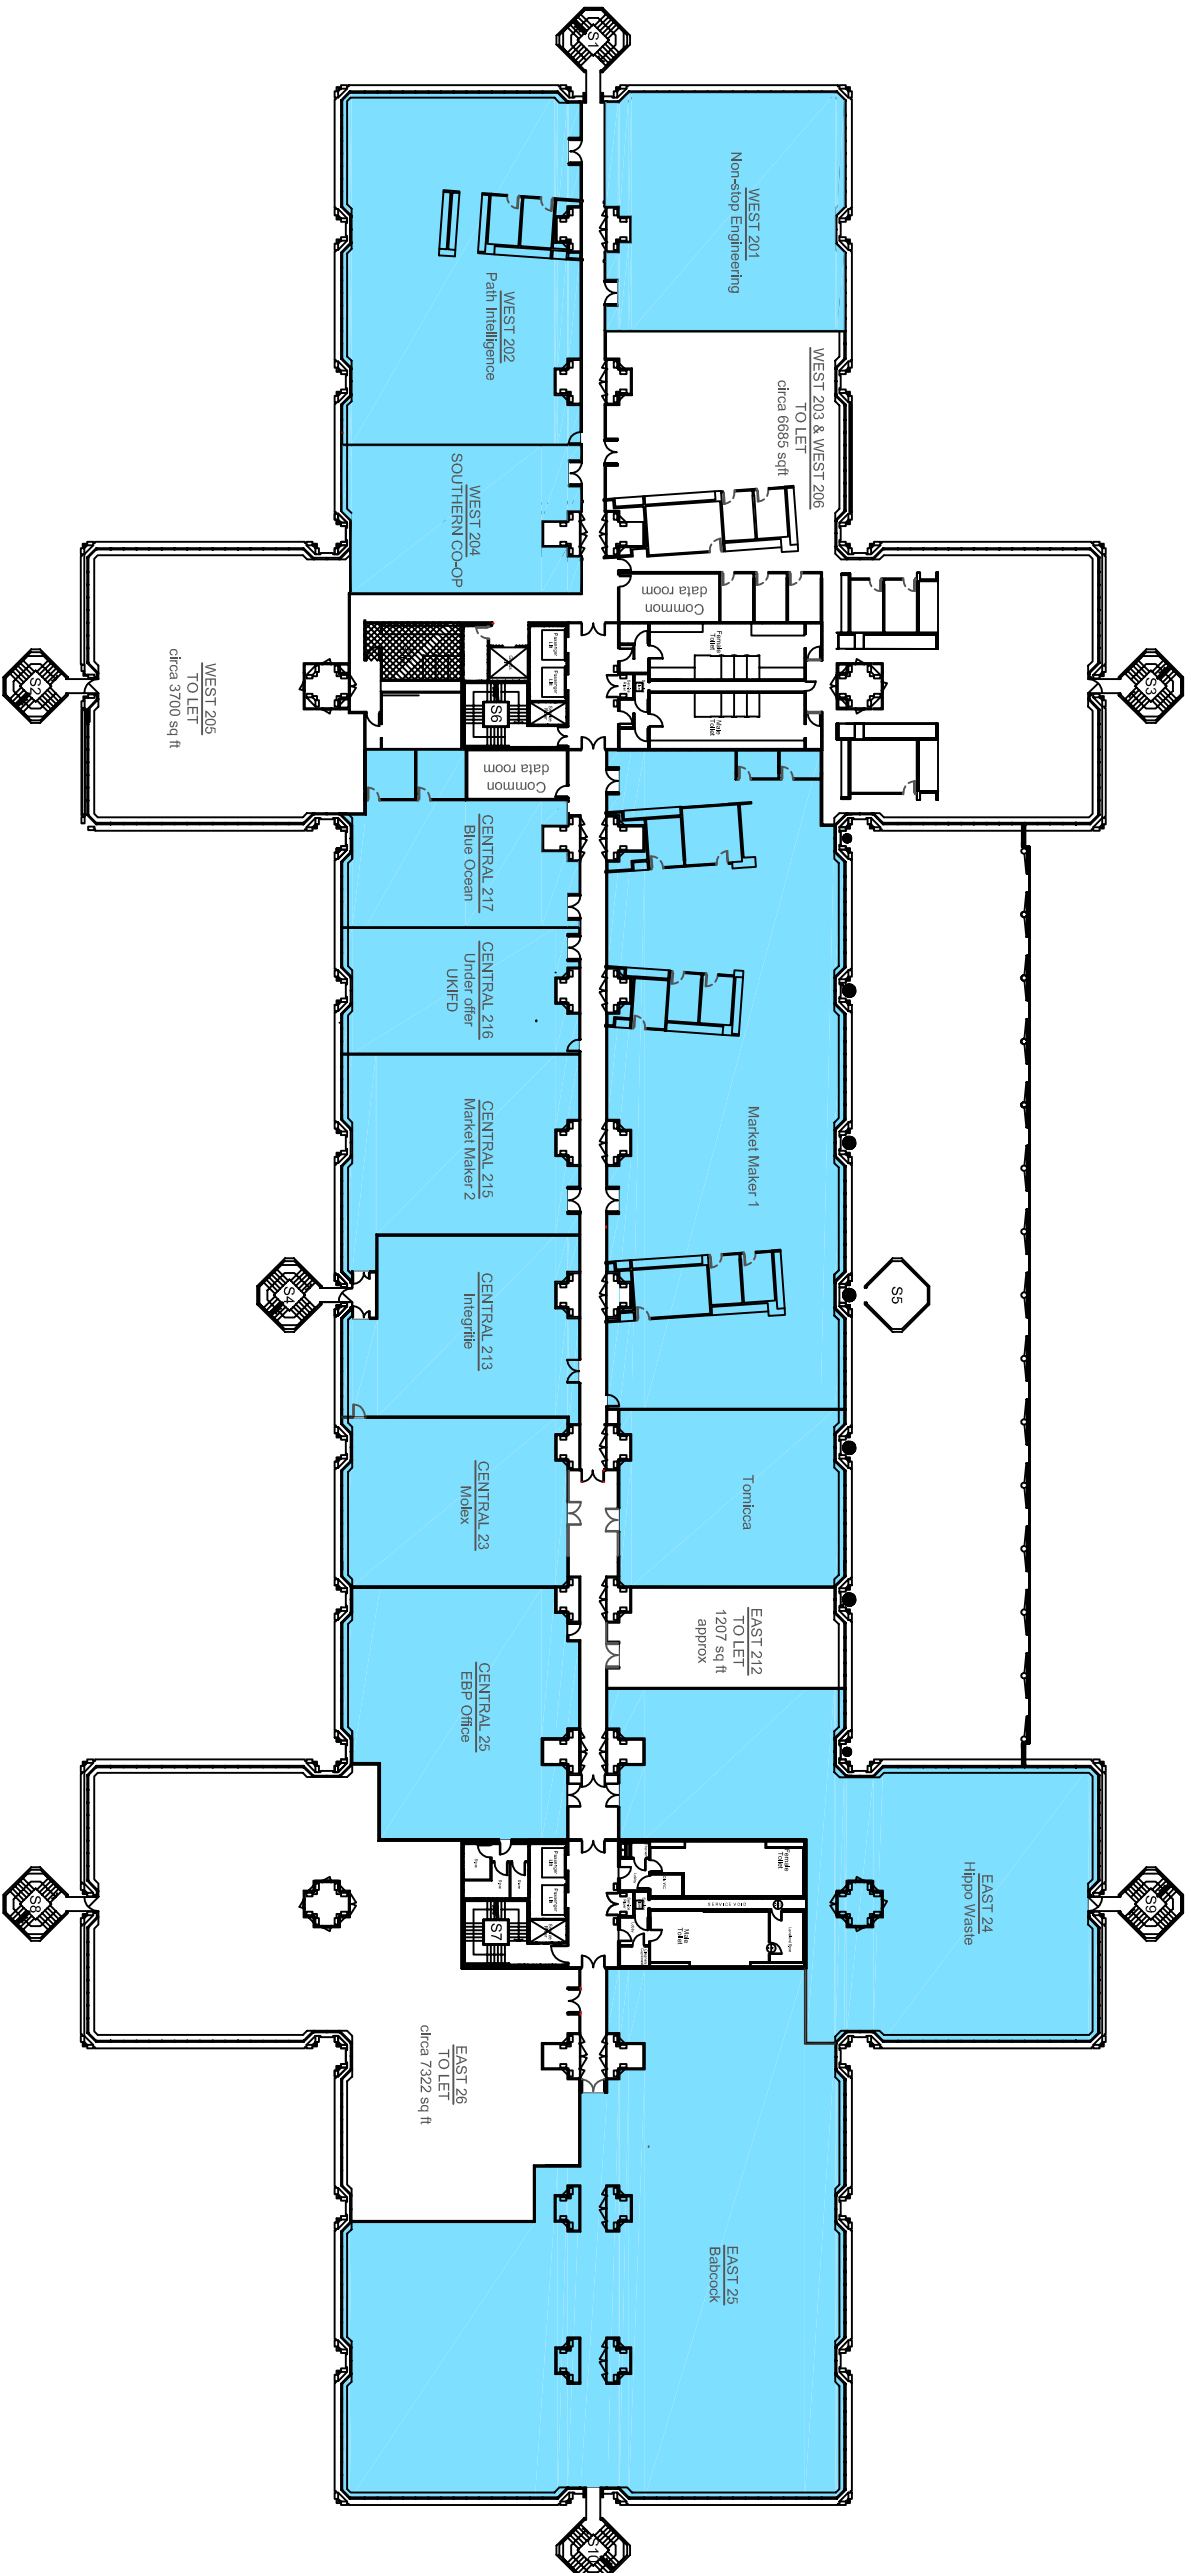

NORTH HARBOUR UNIT TRUST  
 c/o HIGHCROSS STRATEGIC ADVISORS LTD

Project  
 1000 LAKESIDE  
 NORTH HARBOUR

Title  
 SECOND FLOOR AS-BUILT



building surveyors  
 10 Saville Place Clifton Bristol BS8 4EJ  
 T: 0117 900 1638 - F: 0117 970 6006

Date OCTOBER 2011 Drawn by KP

Scale NTS Checked by SH

Drawing No. MASTER LAYOUT Rev. T